


| FILE NO. | DATE | BY | REVISION |
|----------|------|----|----------|
| | | | |
| | | | |
| | | | |

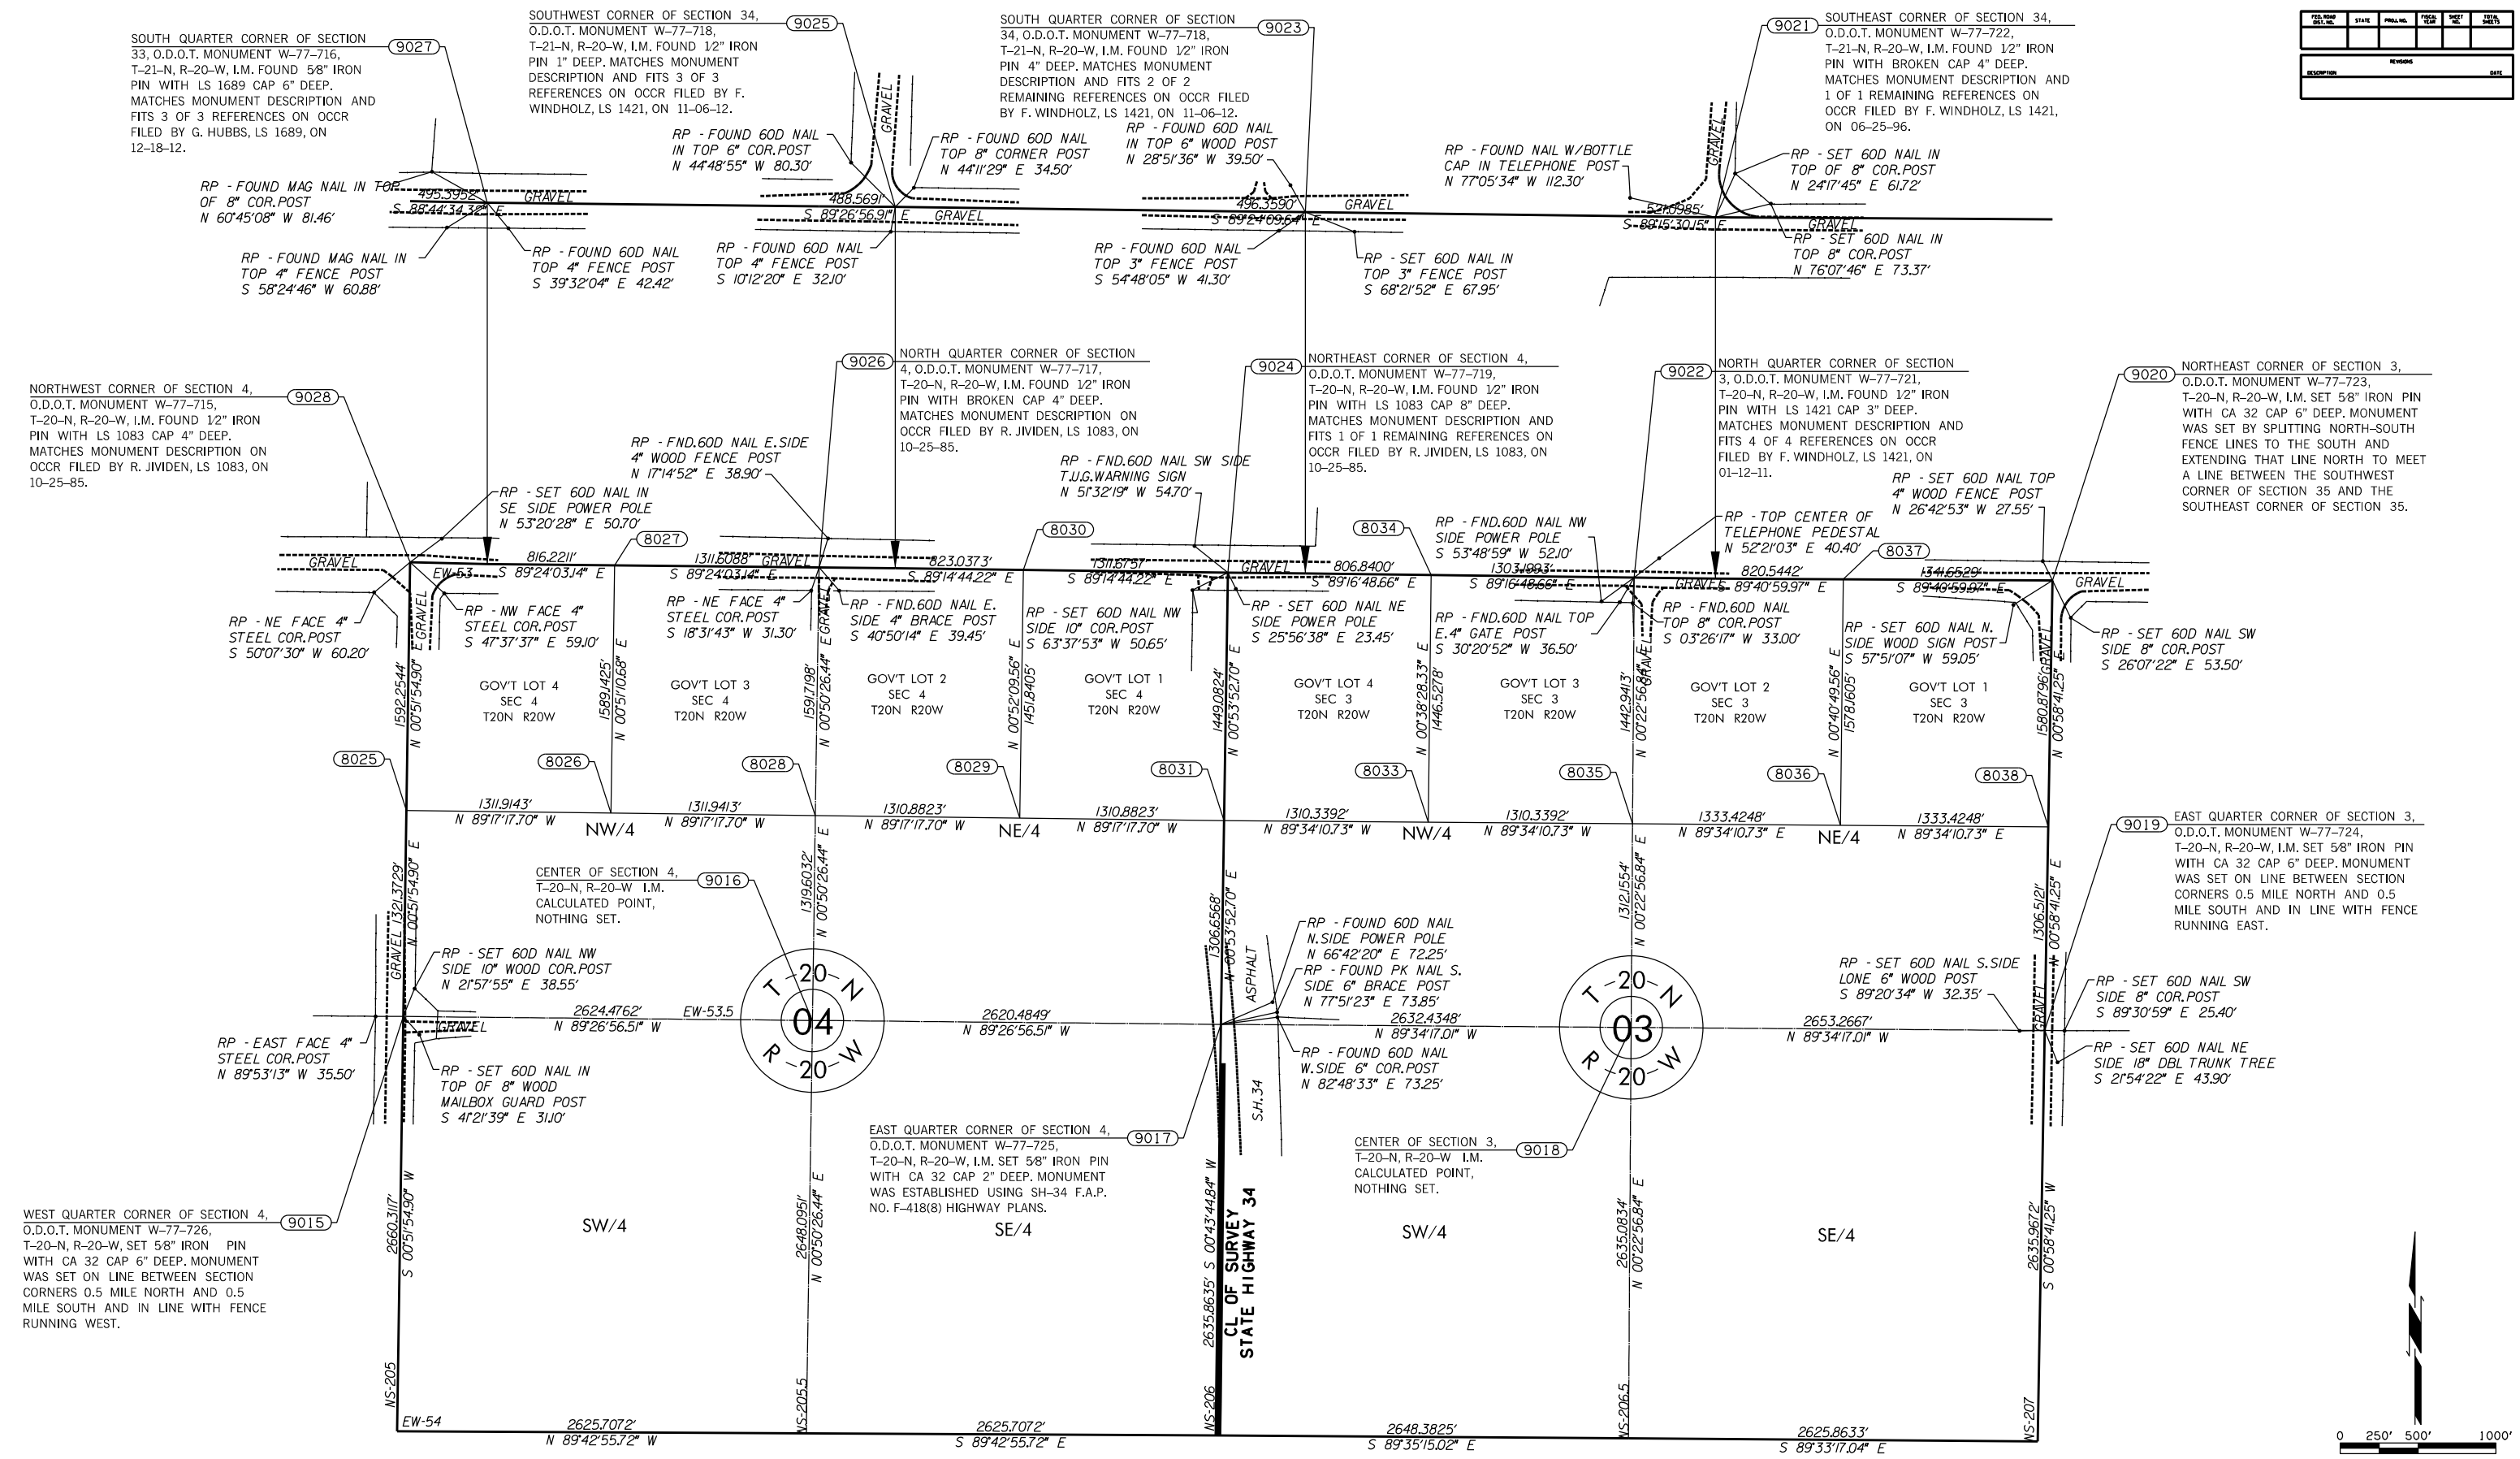

| | | | | |
|------------|--------|---|---|-----------------|
| P.L.S. | J.H.F. | 04/24/13 | SH-34 BRIDGE OVER S. PERSIMMON CREEK, 4.9 MI. N. OF DEWEY COUNTY LINE | WOODWARD COUNTY |
| DRAWN | J.E.M. | 04/24/13 | LAND TIE SHEET | |
| CHECKED | J.H.F. | 04/24/13 | | |
| APPROV. | J.H.F. | 04/24/13 | | |
| CREW CHIEF | T.J.W. | SWO NO. <u>4843W</u> J/P NO. <u>28825(04)</u> SHEET NO. <u>17</u> | | |