


SEC. 2,  
T22N, R17W

SEE SHEET 8 - WL PLAN & PROFILE - N.  
CLEVELAND ST. FOR CLEVELAND ST.

SEC. 1, T22N, R17W

NOTE: WATERLINE DIMENSIONED FROM  
C.R.L. TO CENTER OF PIPE  
(SEE STATIONS & OFFSETS)


ADDENDUM #3 11-15-16  
RECORD DRAWING 4-28-17

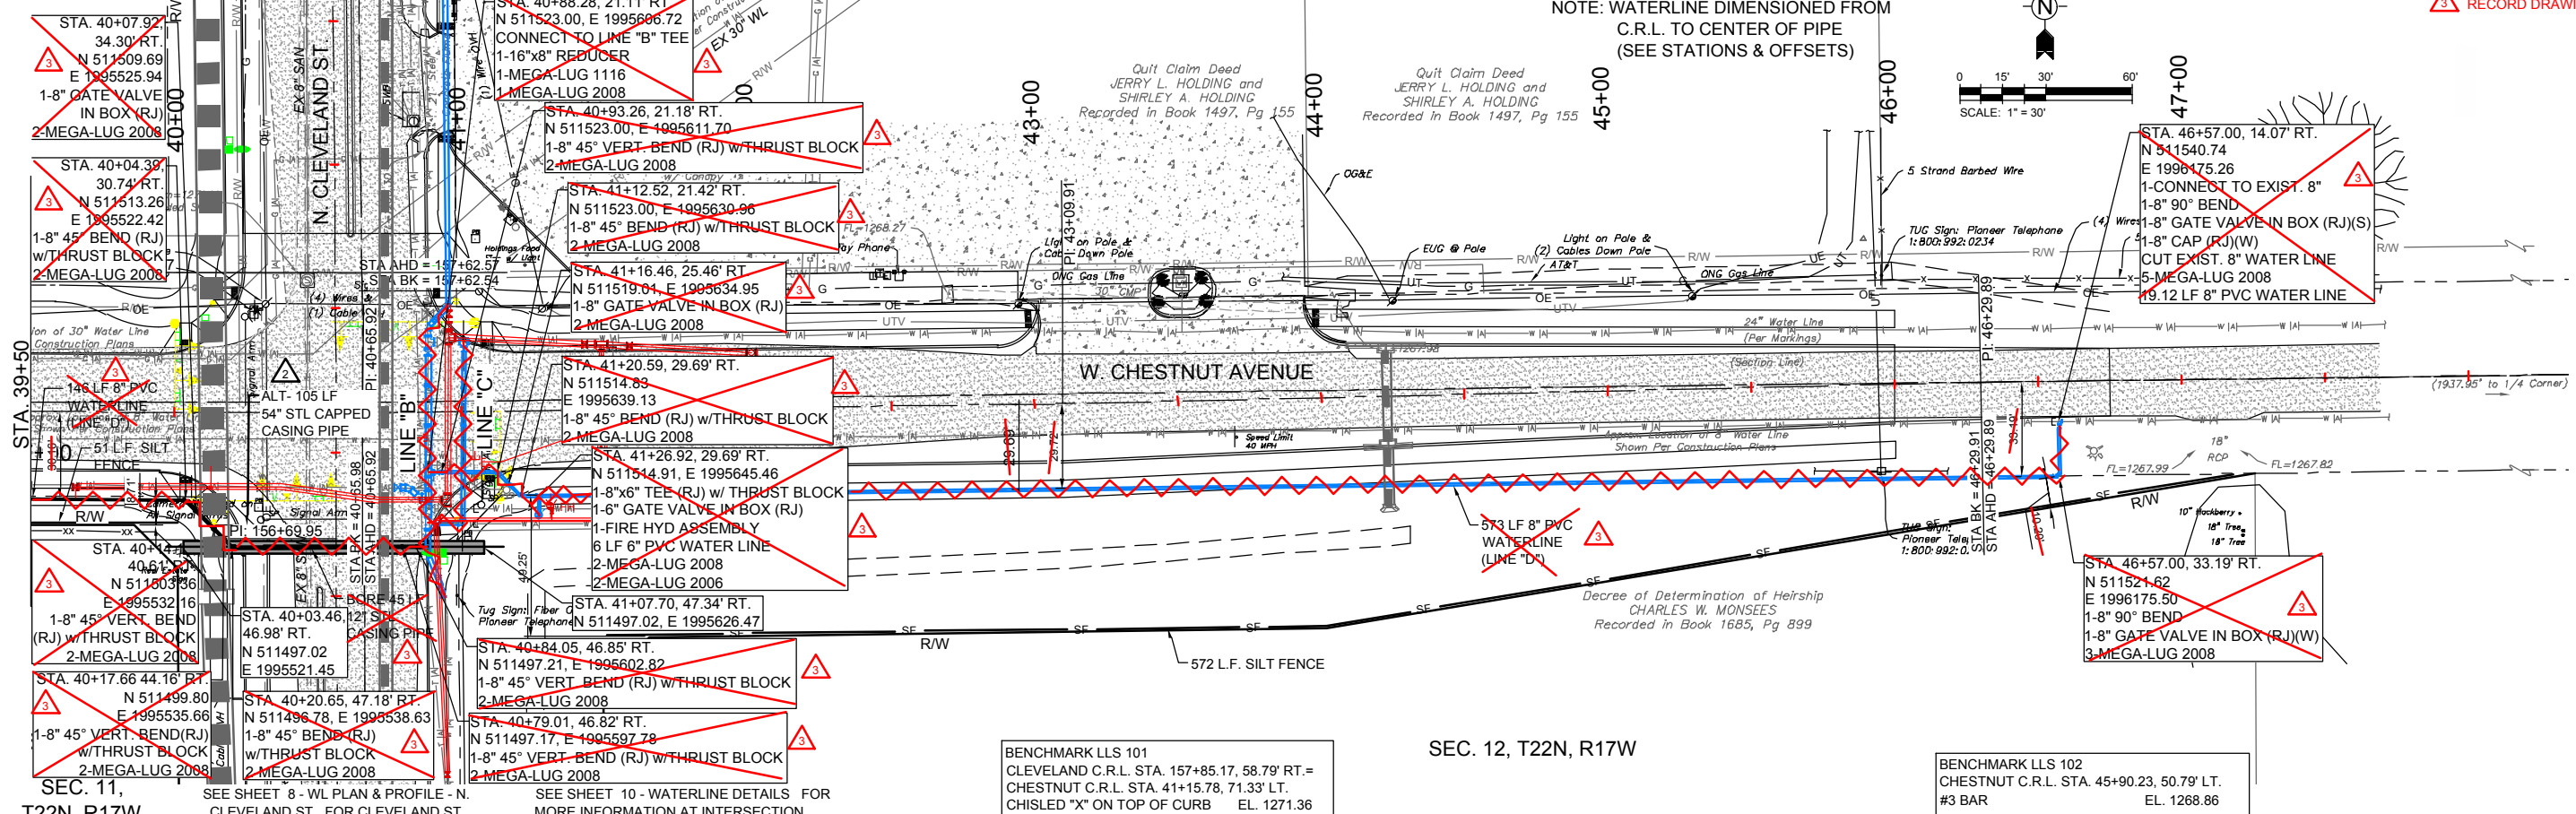

BENCHMARK LLS 102  
CHESTNUT C.R.L. STA. 45+90.23, 50.79' LT.  
#3 BAR EL. 1268.86

BENCHMARK LLS 101  
CLEVELAND C.R.L. STA. 157+85.17, 58.79' RT. =  
CHESTNUT C.R.L. STA. 41+15.78, 71.33' LT.  
CHISLED "X" ON TOP OF CURB EL. 1271.36

LINE "D"

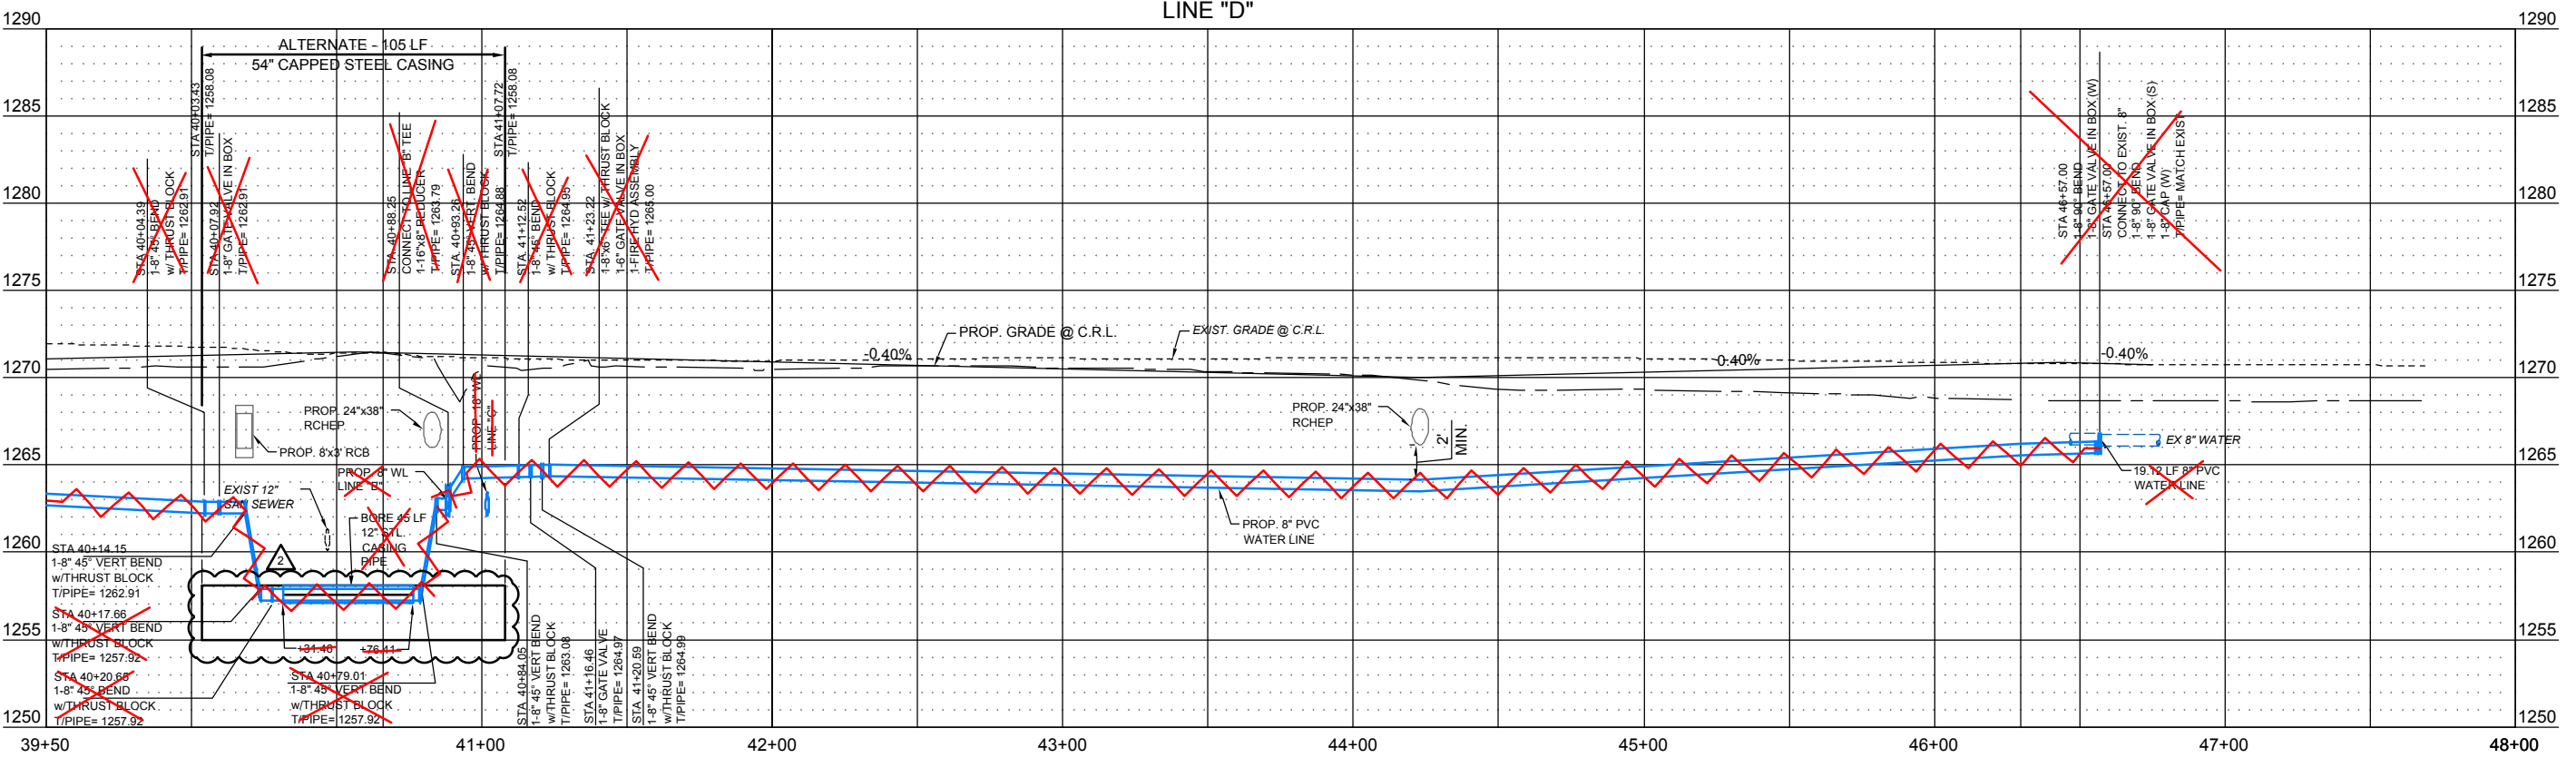

RECORD DRAWING

W. CHESTNUT AVE. - LINE "D"  
CITY PROJECT: W-1406B SHEET NO. 7

GARFIELD COUNTY

9/22/2017 2:00:56 PM - P:\277121\31-27712-13001\CAD\DWG\WATERLINE PLANS\CHESTNUT WTR PLAN & PROFILE 2.DWG - SCHUMACHER, MIKE