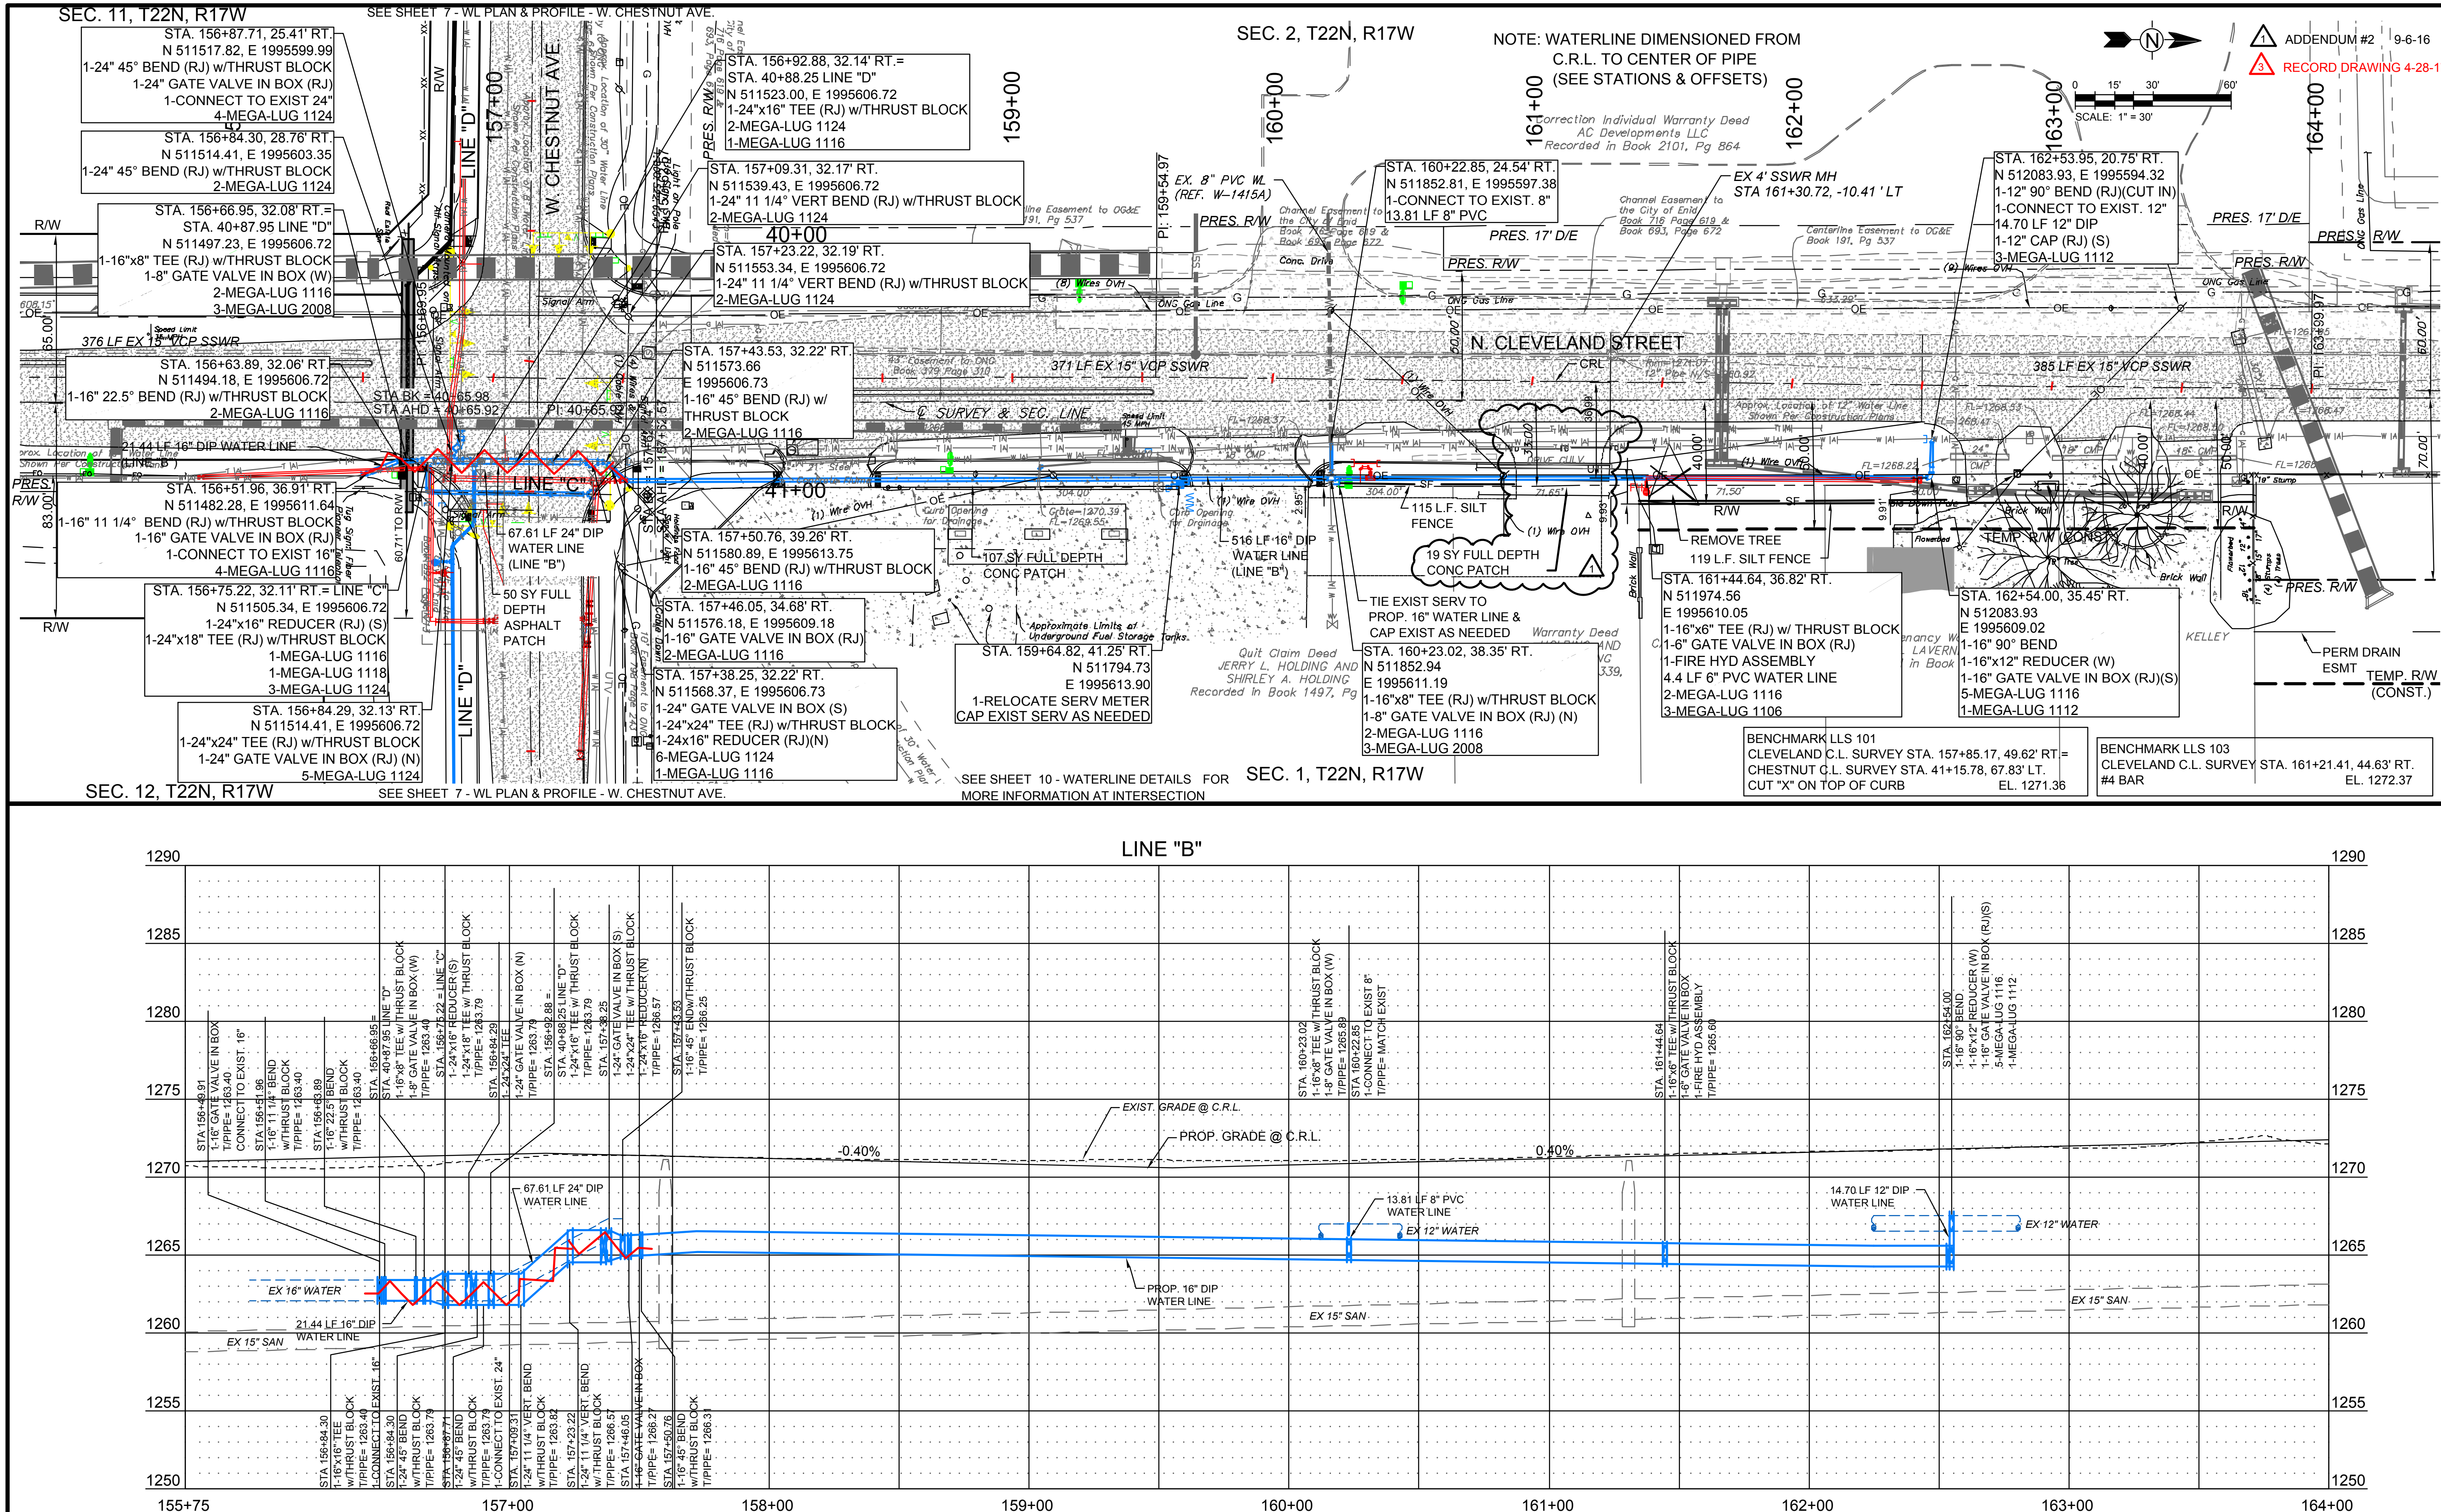


RECORD DRAWING

# N. CLEVELAND ST. - LINE "B"

CITY PROJECT: W-1406B SHEET NO. 8

GARFIELD COUNTY

9/22/2017 2:01:44 PM - P:\27712\131-27712-13001\CAD\SHEETFILES\WATERLINE PLANS\CLEVELAND WTR PLAN & PROFILE.DWG - SCHUMACHER, MIKE